

Compliance Package:

The Architectural Technologist is not responsible for the accuracy of drawings. The drawing date, file no. & the responsible engineering drawing section.

Contractor shall obtain all permits on his own account and report any deficiencies to the Architectural Technologist before proceeding.

Contractor must advise all architect, designer and related documents in the possession of Midano Design Inc. and make the required copy available to the Architectural Technologist and related documents in the possession of Midano Design Inc.

All drawings, specifications and related documents are the copyright property of Midano Design Inc. and must be retained upon request. Reproduction of drawings, specifications and related documents in part or whole, without written permission from Midano Design Inc., is prohibited.

This drawing is not to be scaled.

For Architectural Technologist:

Project No.: 2011-11-11-111111
Drawing No.: 2011-11-11-111111
Date: 2011-11-11
Title: Enclosed Pergola
Section: A-A

No.	Description	Date
1	Architectural Drawing -	2011-11-11

The water supply has been determined and deemed to be sufficient for the proposed building. The water supply is to be connected to the building under Division C, Schedule 1.2 of the Building Code.

Approved water source under Division C, Schedule 1.2 of the Building Code.

FIRM: MIDANO DESIGN INC. - 35440

QUALIFICATION INFORMATION

Project Office Address is located under Division C, Schedule 1.2 of the Building Code.

ANTHONY DEL GROSSO
BORN - 222449




Project Name:

887 GREEN STREET

Title: Proposed
Enclosed Pergola


Scale: 3/16"=1'-0" Project No. 21-25
Date: Dec. 2020 Drawing No. A-1
Project Location: Innisfil, Ont.

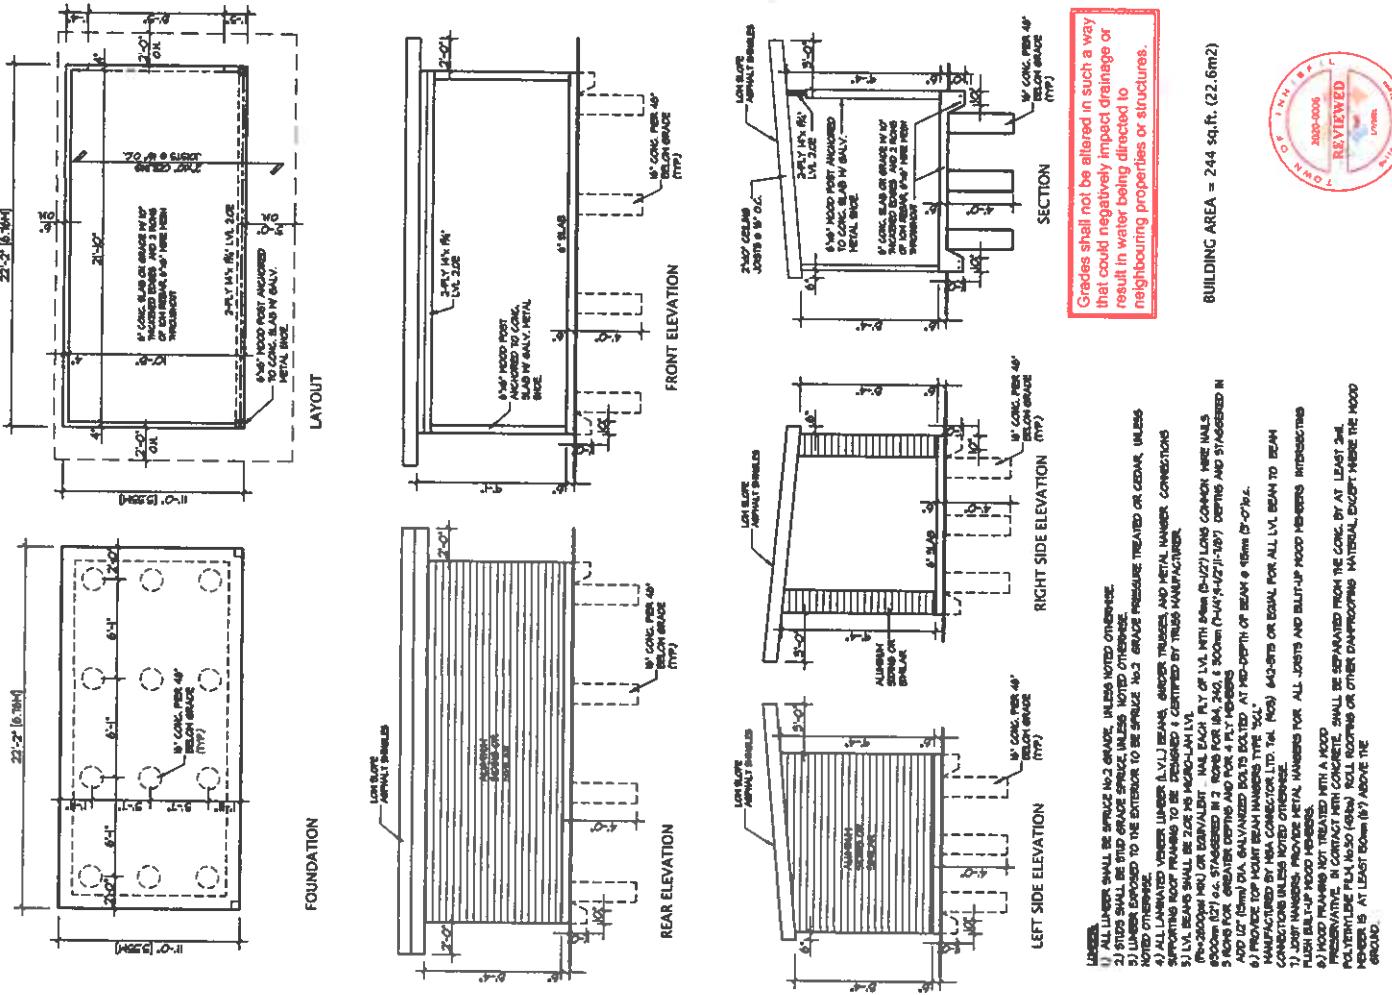

LOT 58
REGISTERED PLAN 51M-XXXX
TOWN OF INNISFIL



GREEN STREET

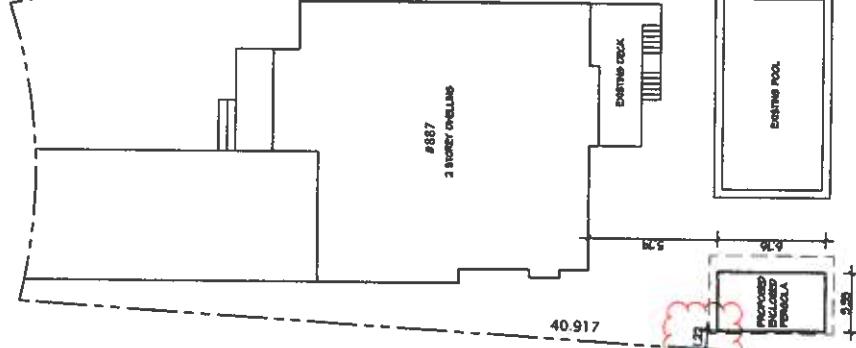

**SCOPE OF WORK:
REVIEWED FOR A NEW
GAZEBO.**

**ALL WORK MUST COMPLY
WITH OBC 2012**

SITE PLAN
NOT TO SCALE



**COMMITTEE OF ADJUSTMENT NOTICE OF PUBLIC HEARING
APPLICATION NO. A-041-2023**

TAKE NOTICE that an application has been received by the Town of Innisfil from **Maurizio Occhiuto, Applicant**, on behalf of **Michelle Keavney, Owner**, for a minor variance from Zoning By-law 080-13, pursuant to Section 45 of the *Planning Act*, R.S.O. 1990, c. P.13, as amended.

The subject property is described legally as **PLAN 51M1099 LOT 58**, is known municipally as **887 Green Street**, and is zoned as "**Residential 1 Exception 26 (R1-26)**".


The applicant has constructed a pergola with a deficient side yard setback of 0.76 metres. The applicant is seeking relief from Section 4.3.3.26 (b) of the Zoning By-law which requires a minimum interior side year setback of 1.2 metres.

The Committee of Adjustment for the Town of Innisfil will consider this application in person at Town Hall and virtually through Zoom on **Thursday, August 17, 2023, at 6:30 PM**.

To participate in the hearing and/or provide comments, you must register by following the link below or scanning the above QR code:
<https://innisfil.ca/en/building-and-development/committee-of-adjustment-hearings.aspx>

Requests can also be submitted in writing to: Town of Innisfil Committee of Adjustment, 2101 Innisfil Beach Road, Innisfil, Ontario, L9S 1A1 or by email to planning@innisfil.ca.

If you wish to receive a copy of the decision of the Committee of Adjustment in respect of the proposed minor variance, you must make a written request to the Secretary-Treasurer of the Committee of Adjustment by way of email or regular mail. The Notice of Decision will also explain the process for appealing a decision to the Local Planning Appeal Tribunal.

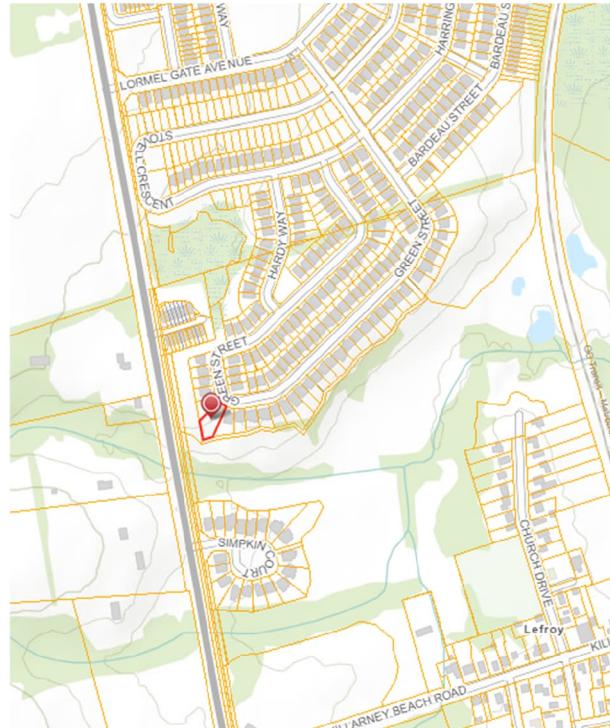

Additional information relating to the proposed application is available on the Town of Innisfil website. Accessible formats are available on request, to support participation in all aspects of the feedback process. To request an alternate format please contact Planning Services at planning@innisfil.ca.

Dated: **August 1, 2023**

Toomaj Haghshenas,
Secretary-Treasurer
thaghshenas@innisfil.ca
705-436-3710 ext. 3316

